


Notes

- Refer to Irrigation As-Built for layout of:
 - Balance Line
 - Pond Overflow
 - Pond Fill Lines
- Surface Area of Ponds
 - North Pond: 3,794.4 m2
 - South Pond: 3,194.4 m2
- Quantity of Water
 - Total quantity of water: 3.6 million gallons
 - Total usable water: 3.4 million gallons

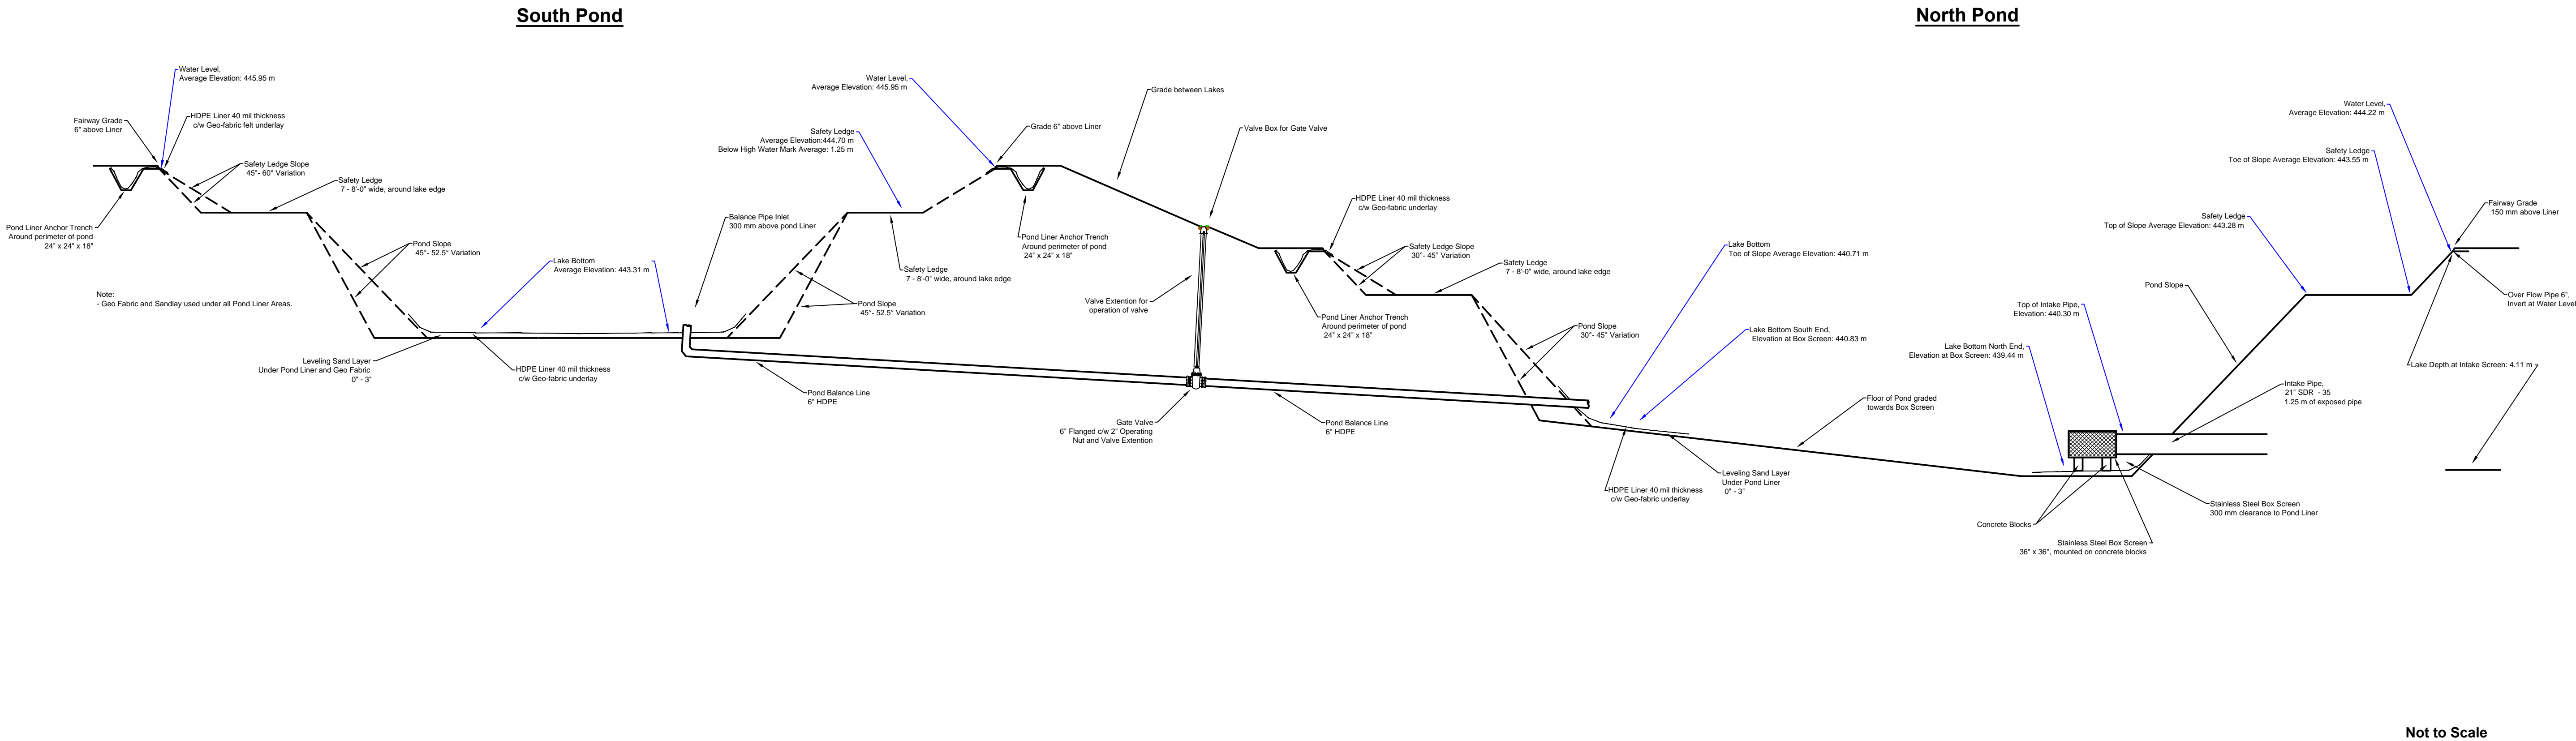

Cross Section Conceptional View



AQUA LAWN SPRINKLER
DIVISION OF DOUBLE D INDUSTRIES LTD.

AQUA LAWN SPRINKLER

AQUA LAWN SPRINKLERS A DIVISION OF DOUBLE D INDUSTRIES LTD.

10141 STAVE LAKE ST.
MISSION, BC
V2V 0B5

CL: 604-657-6272
PH: 604-826-2345
DAN.AQUA@YAHOO.CA

© COPYRIGHT
THIS DRAWING IS AND AT ALL TIMES REMAINS THE EXCLUSIVE PROPERTY OF AQUA LAWN SPRINKLERS A DIVISION OF DOUBLE D INDUSTRIES LTD. AND TURFPLAN. ALL INFORMATION, BPS DATA AND SURVEY POINTS SHALL NOT BE USED IN WHOLE OR IN PART WITHOUT THEIR CONSENT. ANY AND ALL ERRORS OR OMISSIONS ARE TO BE REPORTED TO AQUA LAWN SPRINKLERS AND TURFPLAN. THIS DRAWING IS NOT TO BE SCALED AND SHALL NOT BE USED FOR CONSTRUCTION PURPOSES.

TURFPLAN

TURFPLAN DESIGNS
TURFPLAN CONSTRUCTION INC.

3612 20TH CRESCENT
VERNON, BRITISH COLUMBIA
CANADA V1T 1G1

PH: 250-308-1010
CME.TURFPLAN@GMAIL.COM

COOKE MUNICIPAL GOLF COURSE
PRINCE ALBERT, SASKATCHEWAN



SCALE:	NOT TO SCALE
SHEET SIZE:	24" x 36"
DRAWN BY:	CME
CHECKED BY:	D.FUNK
PROJECT NO:	N/A

REVISIONS:	
PRELIMINARY	2019.12.23

2019.12.31

SUBMITTED