

Fairmont Chateau Whistler Golf Club			
Hole #16			
Feature	Feature ID	M2	Ft2
Green	16 G	441.05	4,747.46
Tees	16 T1	35.96	387.02
	16 T2	65.83	708.54
	16 T3	58.40	628.65
	16 T4	130.02	1,399.49
	16 T5	172.33	1,854.99
	Total	462.54	4,978.69
Fairway	16 F	438.03	4,714.93
Rough	16 R	3,214.28	34,598.17
Bunkers	16 B1	40.32	434.00
	16 B2	87.79	944.95
	Total	128.11	1,378.95
Cart Path	16 CP1	306.94	3,303.91
	16 CP2	192.00	2,066.67
	16 CP3	43.80	471.46
	Total	542.74	5,842.04
Total Area		5,226.75	56,260.25

As-Built Legend									
Manufacturer	ID No.	Description	Symbol	Manufacturer	ID No.	Description	Symbol	Manufacturer	ID No.
Rain Bird	751	Sprinkler, Valve-in-Head, Adjustable Arc, Gear Driven 1" Inlet, Acme Threads, Electric, 80 psi Op. Pres.		IPEX	HDPE	Main Line Pipe, High Density Polyethylene (HDPE) - 12" PE 3408, SDR 13.5, for irrigation use		Rain Bird	1823
Rain Bird	700	Sprinkler, Valve-in-Head, Full Circle, Gear Driven 1" Inlet, Acme Threads, Electric, 80 psi Op. Pres.		IPEX	HDPE	Main Line Pipe, High Density Polyethylene (HDPE) - 10" PE 3408, SDR 13.5, for irrigation use			
Rain Bird	950	Sprinkler, Valve-in-Head, Adjustable Arc, Gear Driven 1-1/2" Inlet, Acme Threads, Electric, 80 psi Op. Pres.		IPEX	HDPE	Main Line Pipe, High Density Polyethylene (HDPE) - 8" PE 3408, SDR 13.5, for irrigation use			
Rain Bird	900	Sprinkler, Valve-in-Head, Full Circle, Gear Driven 1-1/2" Inlet, Acme Threads, Electric, 80 psi Op. Pres.		IPEX	HDPE	Main Line Pipe, High Density Polyethylene (HDPE) - 6" PE 3408, SDR 13.5, for irrigation use			
Rain Bird		Quick Coupler Valve Assembly 1" Female NPT Inlet to fit Quick Coupler Key		IPEX	HDPE	Main Line Pipe, High Density Polyethylene (HDPE) - 4" PE 3408, SDR 13.5, for irrigation use			
Rain Bird		Electric Remote Control Valve Assembly 1-1/2" Female NPT Inlet Complete w/ Pressure Regulation		IPEX	HDPE	Main Line Pipe, High Density Polyethylene (HDPE) - 3" PE 3408, SDR 13.5, for irrigation use			
Crispin or Valmatic	PL10A / 202C	Air Control Valve Assembly 2" Female NPT Gate Valve		IPEX	HDPE	Lateral Line Pipe, High Density Polyethylene (HDPE) - 3" PE 3408, SDR 13.5, for irrigation use			
Clow, Mueller		Gate Valve Assembly (For Mainline Pipe Isolation) - 4" to 10" As Line Size, Gate Valve Flanged for HDPE Systems See Detail and Specification		IPEX	HDPE	Lateral Line Pipe, High Density Polyethylene (HDPE) - 2" PE 3408, SDR 13.5, for irrigation use			
		Isolation Valve Assembly (For Lateral Line Piping Isolation) - 3" 3" Flanged Valve							
		Isolation Valve Assembly (For Lake Fill and Wash Pad) - 2" Lake Fill c/w Wire							
Grounding Measurements:							As of: Sept. 10, 2019		
Satellite Number							Resistance (Measured in ohms)		
01							6.3		
02							4.8		
03							5.9		
04							7.0		
05							9.4		
06							4.5		
07							4.1		
08							4.4		
09							8.2		
10							7.7		
11							6.4		
12							8.3		
13							7.2		
14							6.4		
15							5.9		
16							4.9		
17							3.6		
18							8.2		

AQUA LAWN SPRINKLER

AQUA LAWN SPRINKLERS A DIVISION OF DOUBLE D INDUSTRIES LTD.

10141 STAVE LAKE ST.

MISSION, BC

V2Y 0B5

CL: 604-657-6272

PH: 604-826-2345

DAN.AQUA@YAHOO.CA

© COPYRIGHT
THIS DRAWING IS AND AT ALL TIMES REMAINS THE EXCLUSIVE PROPERTY OF AQUA LAWN SPRINKLERS A DIVISION OF DOUBLE D INDUSTRIES LTD. AND TURFLAN. ALL INFORMATION, GPS DATA AND SURVEY POINTS SHALL NOT BE USED IN WHOLE OR IN PART WITHOUT THEIR CONSENT. ANY AND ALL ERRORS OR OMISSIONS ARE TO BE REPORTED TO AQUA LAWN SPRINKLERS AND TURFLAN. THIS DRAWING IS NOT TO BE REPRODUCED OR COPIED FOR CONSTRUCTION PURPOSES.

TURFLAN

TURFLAN DESIGNS

TURFLAN CONSTRUCTION INC.

3612 20TH CRESCENT

VERNON, BRITISH COLUMBIA


CANADA V1T 1G1

PH: 250-308-1010

CME.TURFLAN@GMAIL.COM

FAIRMONT CHATEAU WHISTLER GOLF CLUB

WHISTLER, BRITISH COLUMBIA

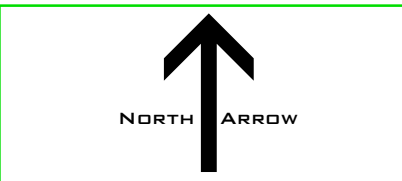

SCALE:	1:500
SHEET SIZE:	24" x 36"
DRAWN BY:	CME
CHECKED BY:	D.FUNK
PROJECT NO:	N/A

REVISIONS:	
PRELIMINARY	2020.01.27

2020.01.27

PRELIMINARY

HOLE NO. 16

IRRIGATION AS-BUILT

1 of 1